Addition Kitchen Space

WINDOW DETAILS 1" = 1'-0"

WINDOW DETAILS 1" = 1'-0"

WALL TYPES 1" = 1'-0"

FIRST FLOOR PLAN
1/4" = 1' – 0"


HEISLER ARCHITECTS
2819 NORTH DOWNER AVE.
MILWAUKEE, WISC. 53211
V 414-962-9094 F 414-962-6498


FIRST FLOOR PLAN

P & M PUB & GRUB
6533 WEST MITCHELL ST.
WEST ALLIS WISC. 53214
V 414-321-1419

98106

21 JUNE 99

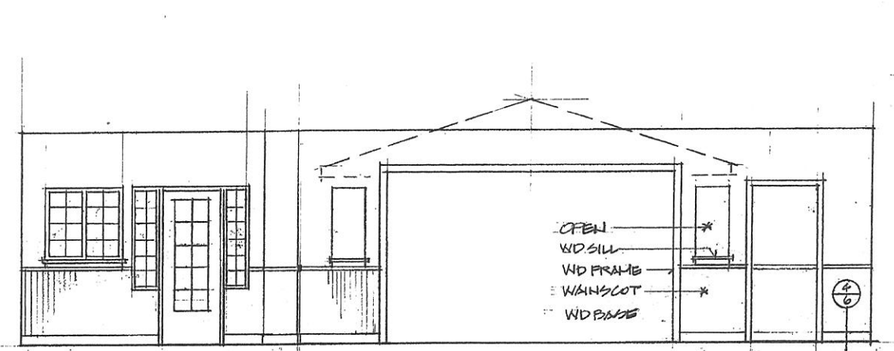


1 ELEVATION EAST WALL BAR AREA
6 1/4" = 1'-0"

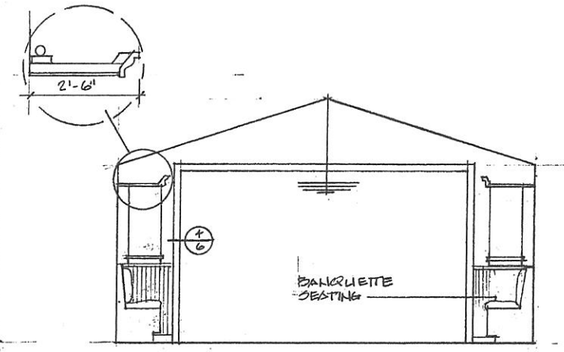


2 ELEVATION WEST LOUNGE
6 1/4" = 1'-0"

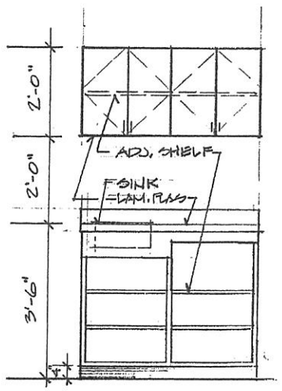


3 WAIT STATION
6 1/2" = 1'-0"

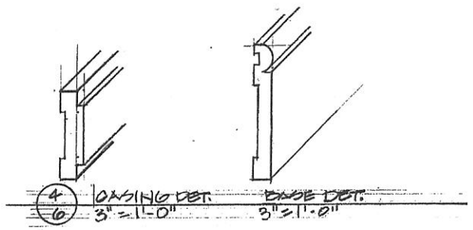


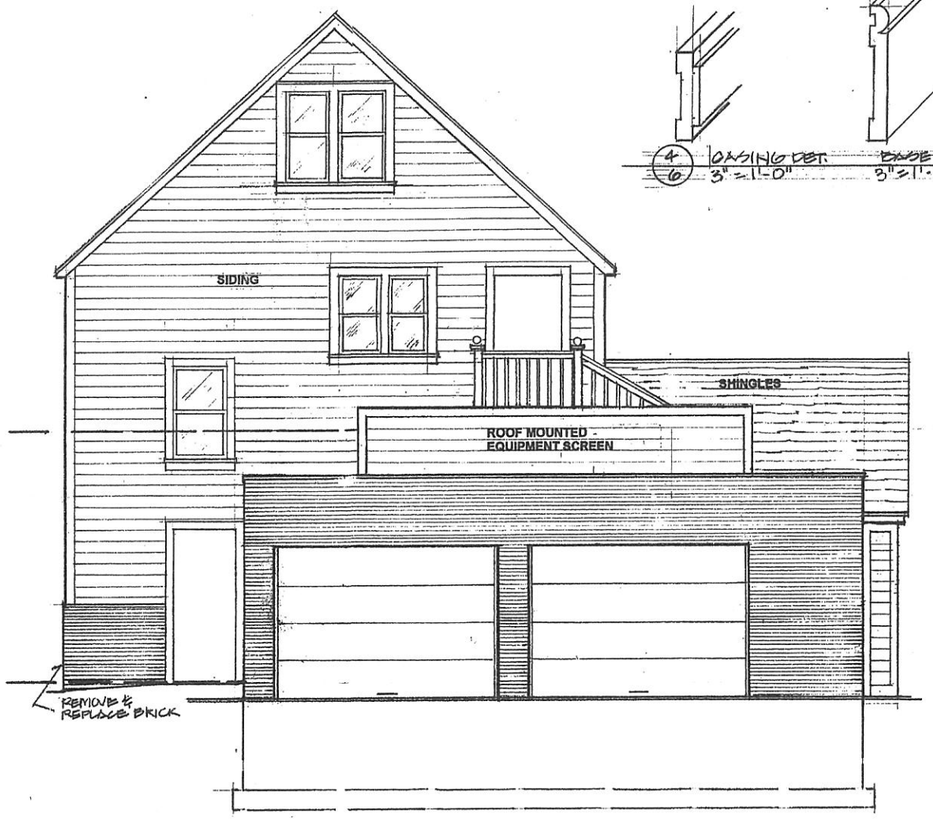


**SOUTH ELEVATION**
1/4 " = 1' – 0"

**BUILDING SIGNAGE**

| | | | |
|---|---|---|---|
| FIELD | BLUE SHERMAN WILLIAMS | | #1231 |
| LETTERS | GOLD | " | #1765 |
| STARS | RED | " | #1007 |
| TRIM COLOR | WHITE | " | #1426 |

SIGNAGE
2' X 22' = 44 SQ.FT.
2' X 3' = 6 SQ.FT.
TOTAL 50 SQ.FT.

~~BUILDING LENGTH~~
~~43.5' + 38' = 86.5'~~
~~86.5 X .8 = 69.2 SQ.FT.~~

~~BUILDING/SIGN~~
~~LIGHTING FIXTURE~~

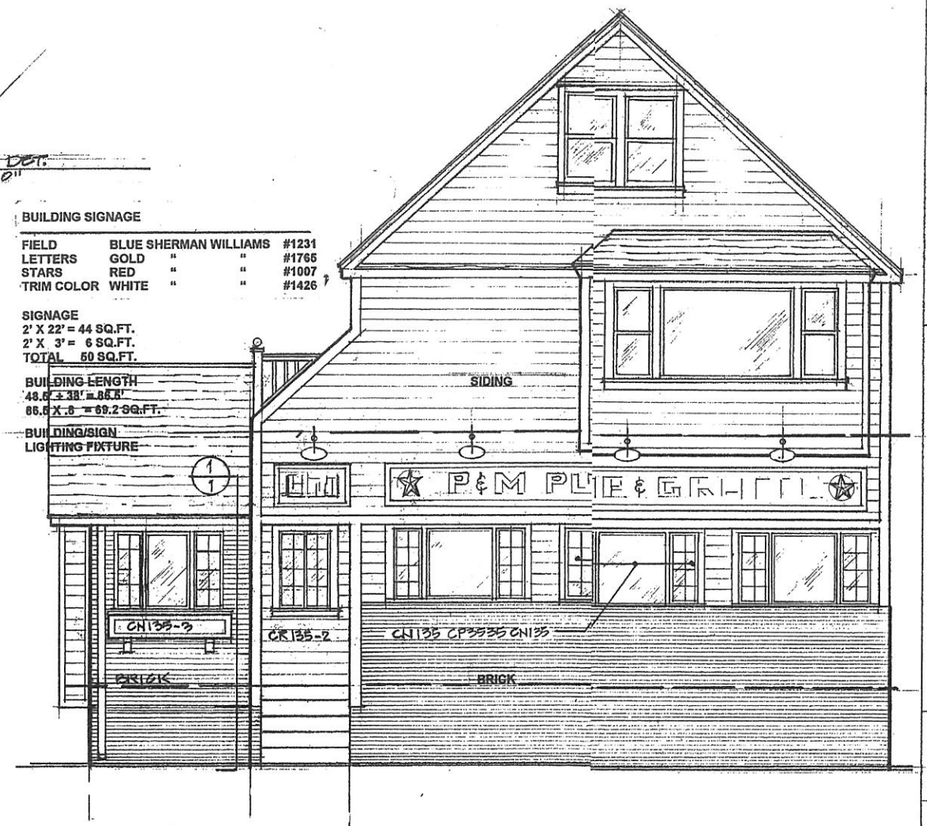


**NORTH ELEVATION**
1/4" = 1' - 0"

**HEISLER ARCHITECTS**
2819 NORTH DOWNER AVE.
MILWAUKEE, WISC. 53211
V 414-962-9094 F 414-962-6498

**ELEVATIONS**

**P & M PUB & GRUB**
6533 WEST MITCHELL ST.
WEST ALLIS WISC. 53214
V 414-321-1419

98106

21 JUNE 99

4 OF 6

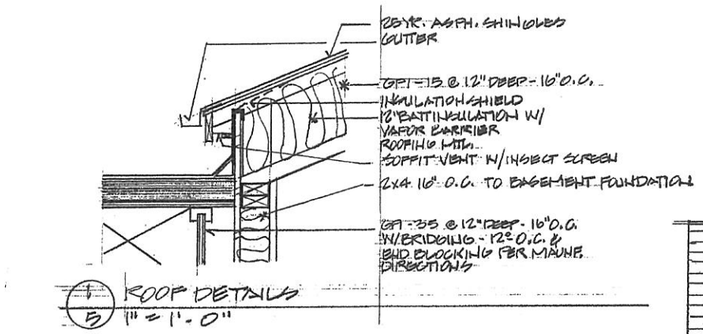


5 ROOF DETAILS
1" = 1'-0"




2/5 EQUIPMENT SCREEN
1/2" = 1'-0"

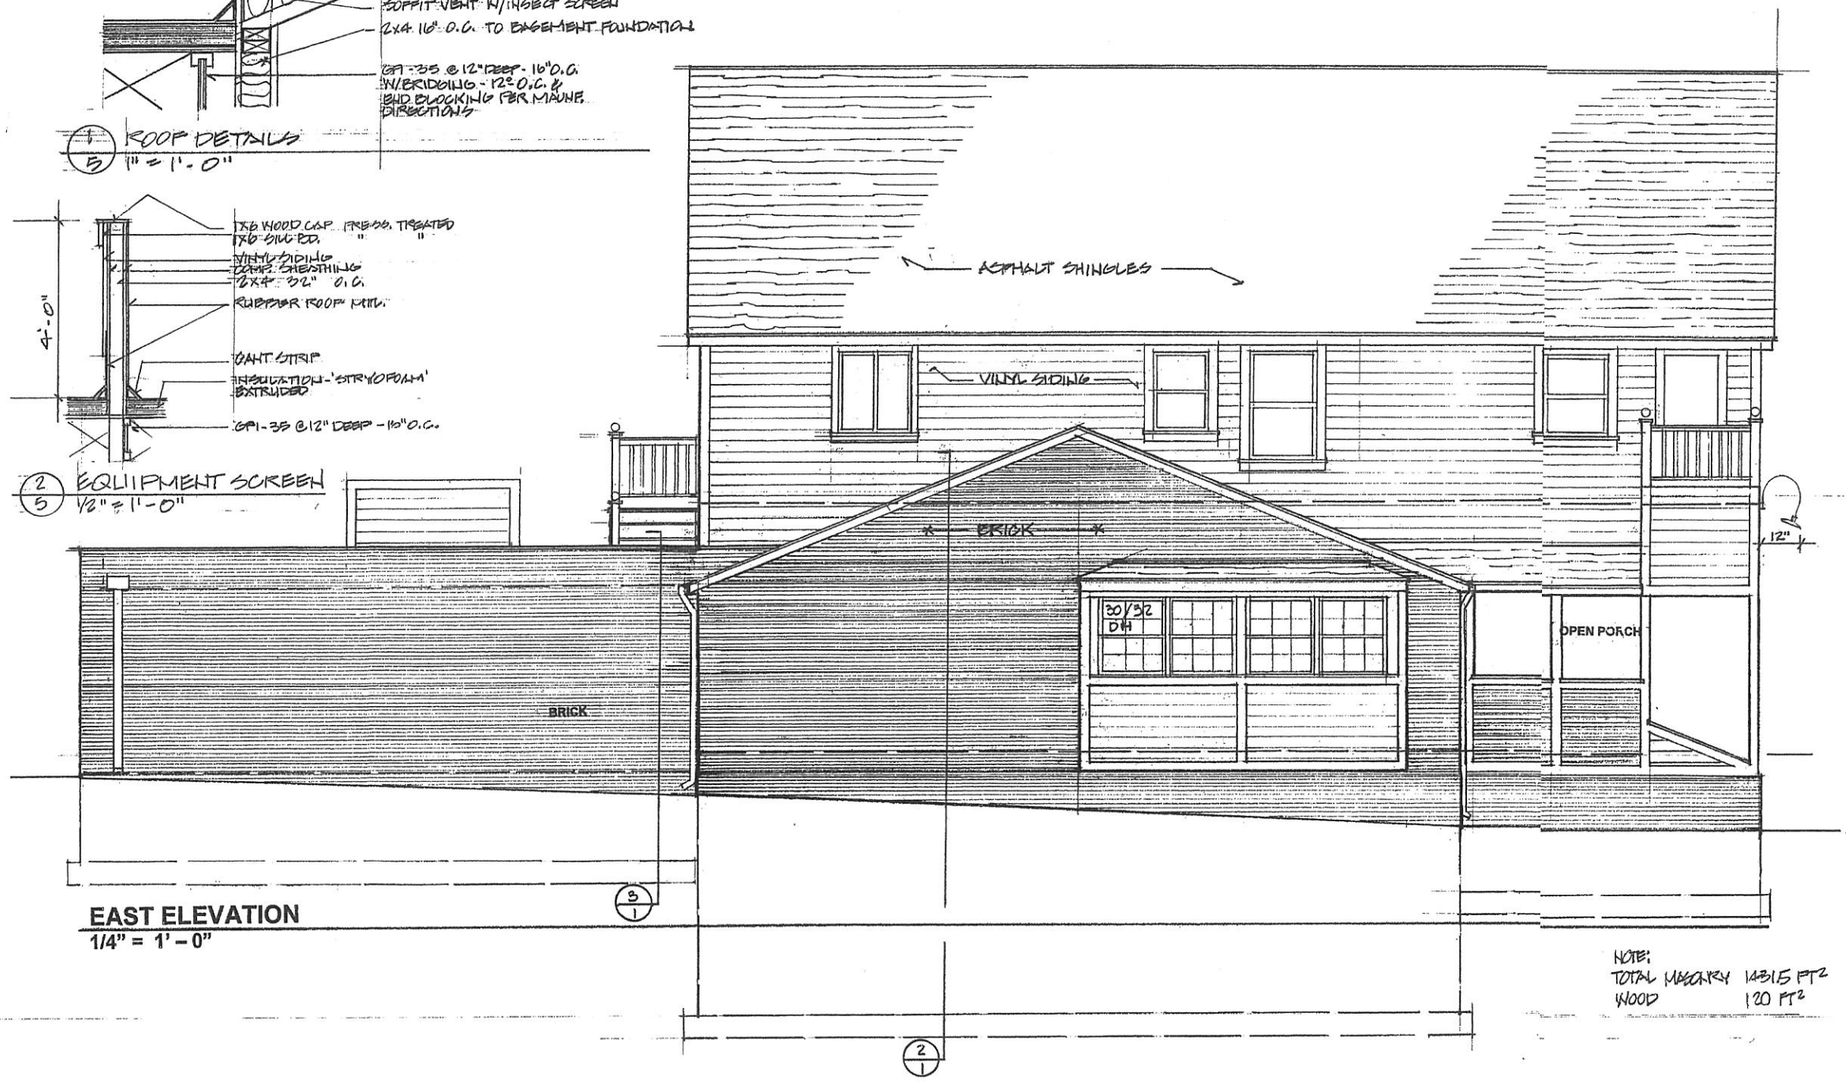


**EAST ELEVATION**
1/4" = 1' – 0"

NOTE:
TOTAL MASONRY 1431.5 FT²
WOOD 120 FT²

**HEISLER ARCHITECTS**
2819 NORTH DOWNER AVE.
MILWAUKEE, WISC. 53211
V 414-962-9094 F 414-962-6498

ELEVATION

**P & M PUB & GRUB**
6533 WEST MITCHELL ST.
WEST ALLIS WISC. 53214
V 414-321-1419

98106

21 JUNE 99

5 OF 6

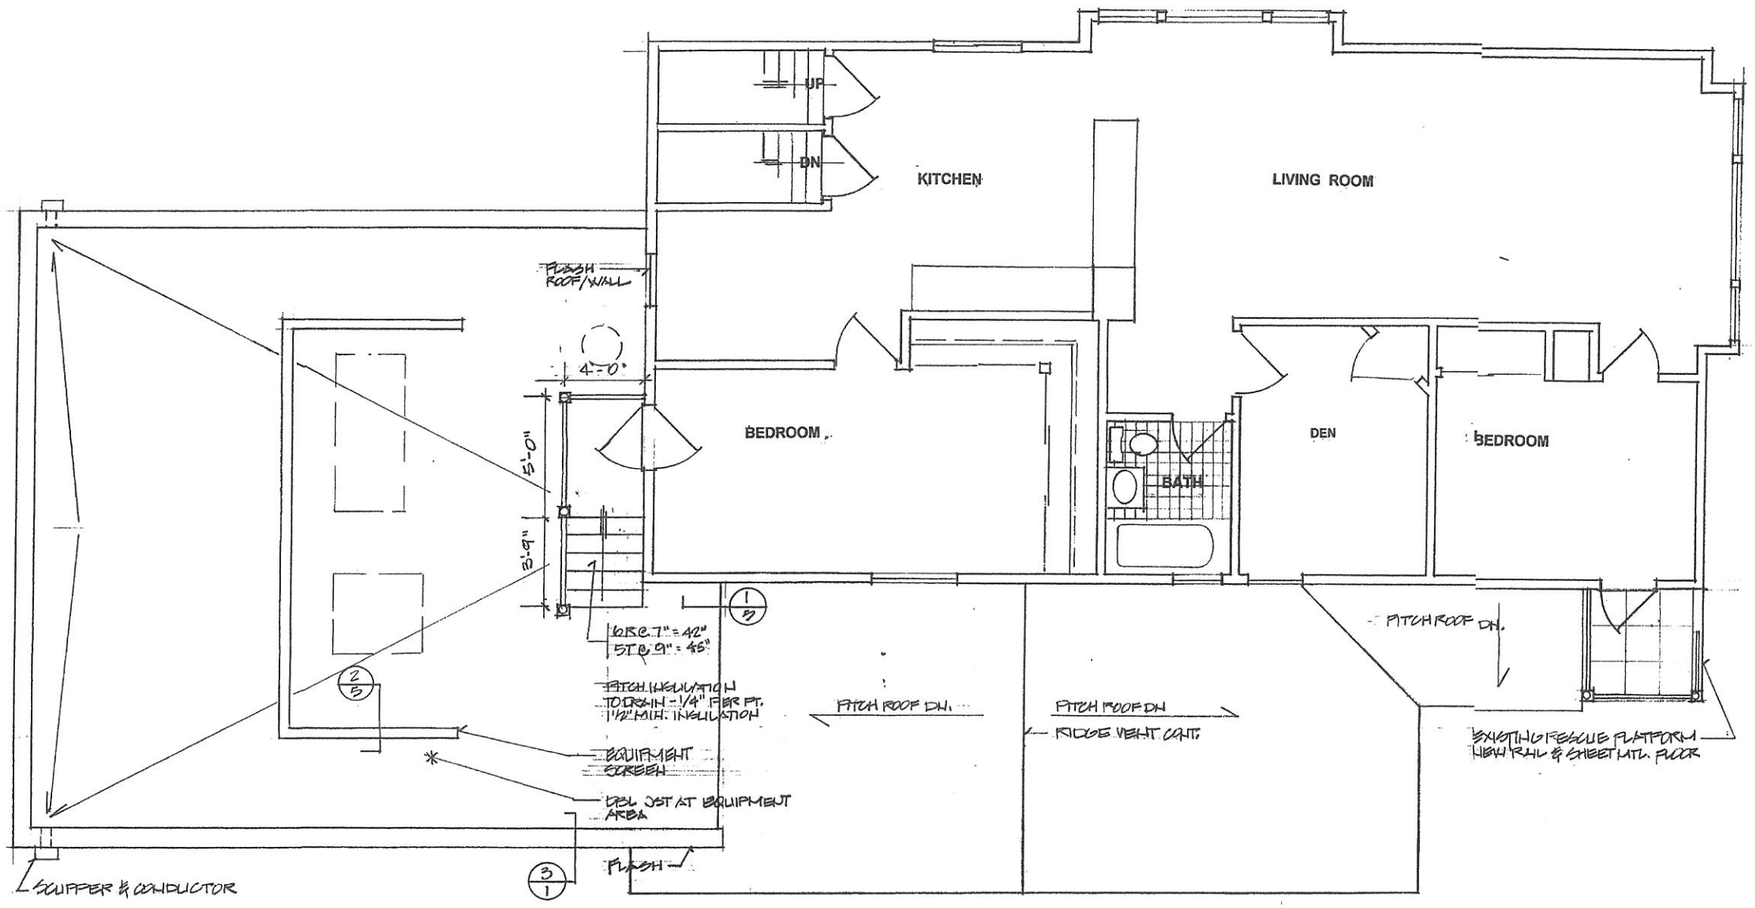


EXISTING 2ND FLOOR & ROOF PLAN
1/4" = 1'-0"

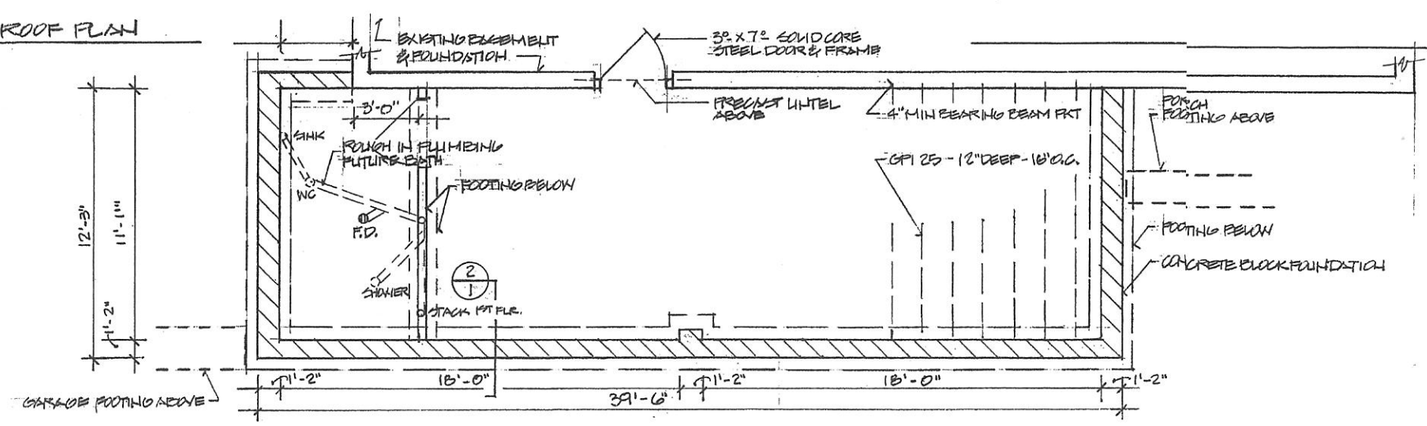


BASEMENT PLAN
1/4" = 1'-0"

HEISLER ARCHITECTS
2819 NORTH DOWNER AVE.
MILWAUKEE, WISC. 53211
V 414-962-9094 F 414-962-6498

SECOND FLOOR PLAN

P & M PUB & GRUB
6533 WEST MITCHELL ST.
WEST ALLIS WISC. 53214
V 414-321-1419

98106

21 JUNE 99

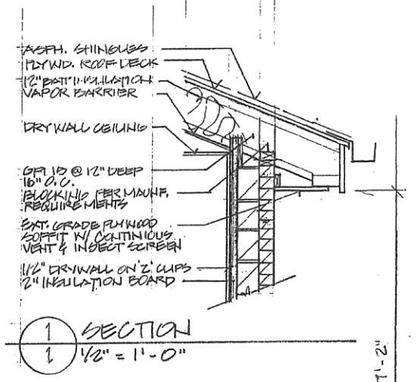


1 SECTION
1/2" = 1'-0"

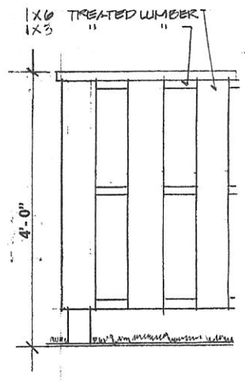


FENCE ELEVATION
SCALE : 3/4" = 1'-0"

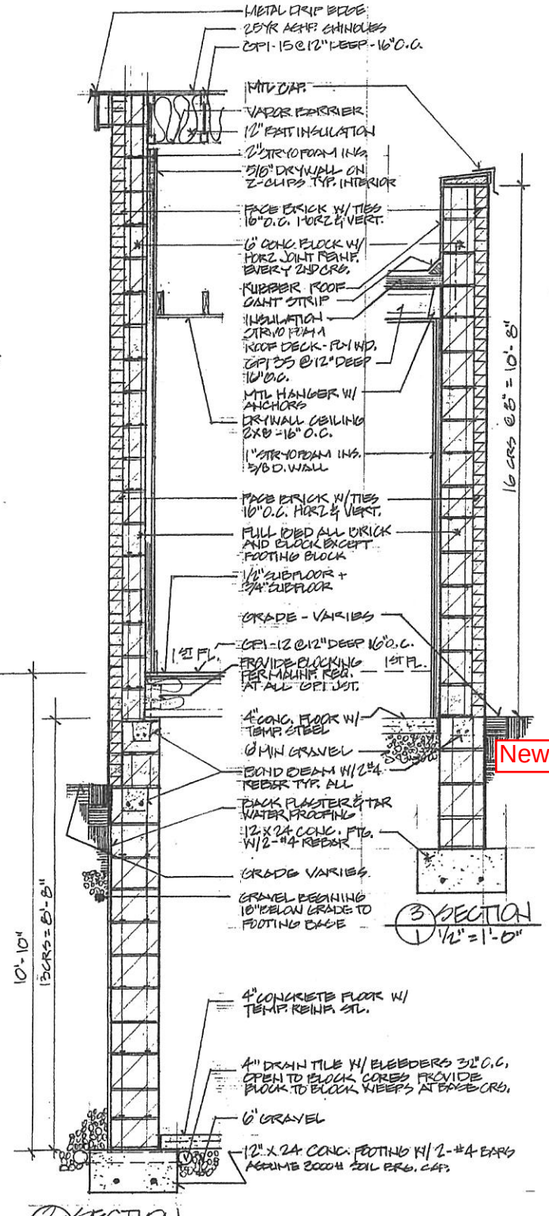


3 SECTION
1/2" = 1'-0"

2 SECTION
1/2" = 1'-0"

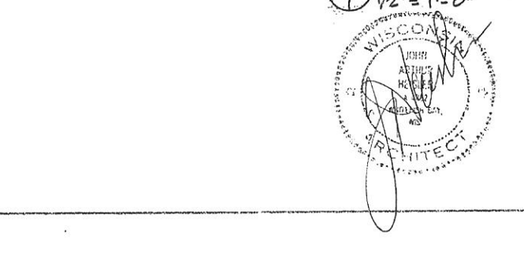


INDEX OF SHEETS

1. SITE PLAN SECTIONS
2. FIRST FLOOR PLAN
3. BASEMENT & SECOND FLOOR PLAN
4. NORTH & SOUTH ELEVATION
5. EAST ELEVATION & DETAILS
6. WEST ELEVATION & DETAILS

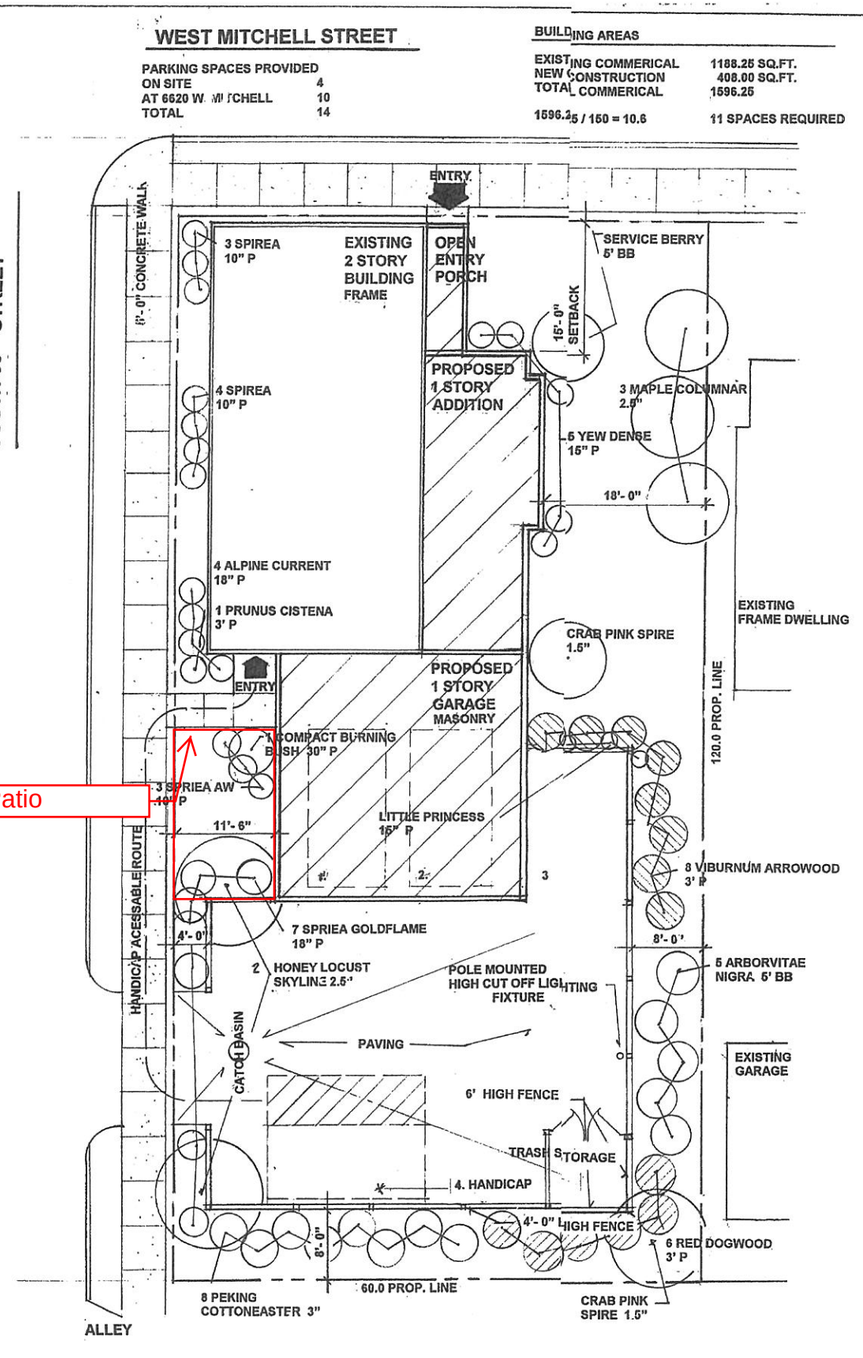


SITE PLAN
SCALE: 1" = 10'-0"

HEISLER ARCHITECTS
2819 NORTH DOWNER AVE.
MILWAUKEE, WISC. 53211
V 414-962-9094 F 414-962-6498

SITE PLAN

P & M PUB & GRUB
6533 WEST MITCHELL ST.
WEST ALLIS WISC. 53214
V 414-321-141

98106

21 JUNE 99

1 OF 6

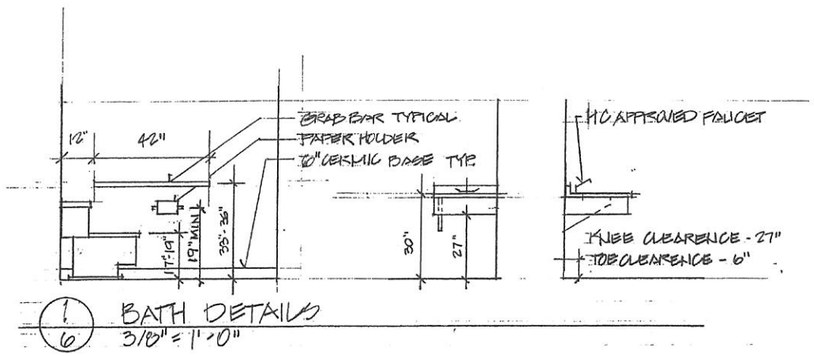


1/6 BATH DETAILS
3/8" = 1'-0"

## ROOM FINISH SCHEDULE

| NO | NAME | FLR. | BASE | WALL | CEILING | CL. HT. | REMARKS |
|---|---|---|---|---|---|---|---|
| 1. | BAR/SEATING | CT. | WD. | DW. PT. | 2X4 AC | 9' 6" | WAINSCOT |
| 2. | LOUNGE | CPT. | WD. | DW. PT. | 2X4 AC | 8' 0" + | WAINSCOT |
| 3. | MENS REST RM. | CT. | 6" CT. | DW. PT. | DW. PT. | 8' 0" | PER A.D.A. REG. |
| 4. | WOMENS REST RM. | CT. | 6" CT. | DW. PT. | DW. PT. | 8' 0" | PER A.D.A. REG |
| 5. | KITCHEN | Q.TC. | 6" QT | KB. | 2X4 KB | 8' 0" | |
| 6. | CORRIDOR | CT. | WD. | DW. PT. | 2X4 AC | 8' 0" | |
| 7. | CORRIDOR | CT. | WD. | DW. PT. | DW. PT. | VARI. | |
| 8. | GARAGE | CONC. | NA. | DW. PT. | DW. PT. | VARI. | |
| 9. | BASEMENT | CONC. | NA. | NA. | | 8' 6" | |

CPT. = CARPET
N.A. = NOT APPLICABLE
Q.T. = QUARRY TILE
Q.T.C. = Q. T. WIRE CUT
CONC. = CONCRETE
KB = KEM BOARD FRP.
V.T. = VINYL TILE
V.B. = VINYL BASE
EXST = AS EXISTING
WB PT. = WONDER BD. PAINT
CB. PT. = CONC. BLK. PAINT
DW. PT. = DRYWALL PAINT
AC = ACOUSTIC TILE
C.T. = CERAMIC TILE
WD = WOOD
GB = WATER PRF DW.

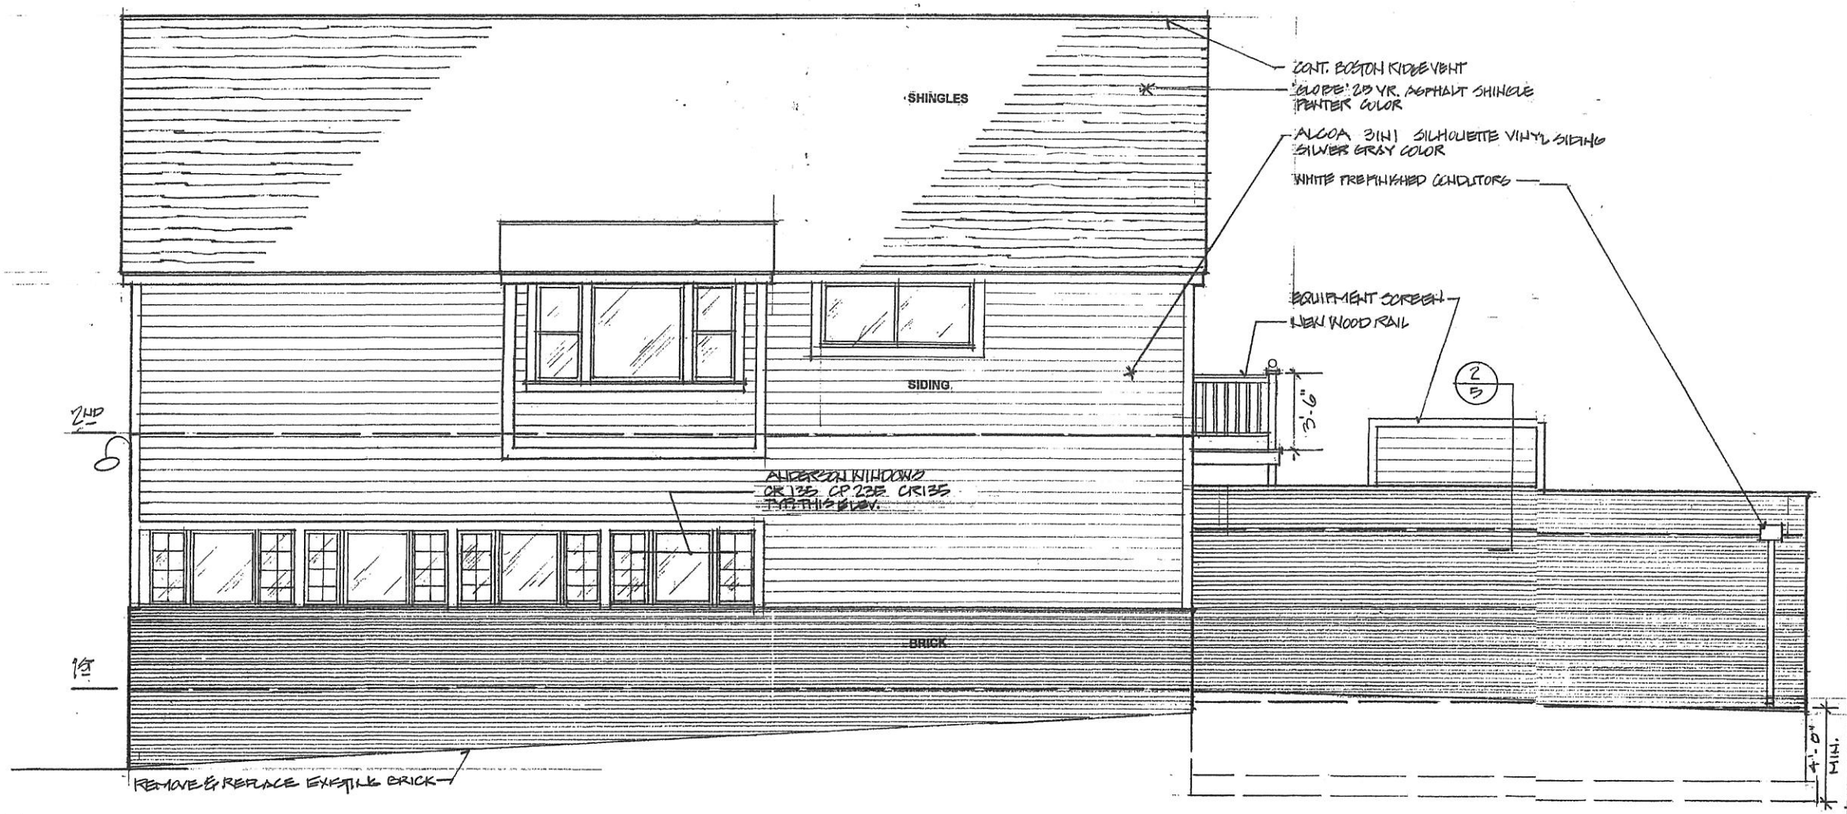


**WEST ELEVATION**
1/4" = 1' – 0"

HEISLER ARCHITECTS
2819 NORTH DOWNER AVE.
MILWAUKEE, WISC. 53211
V 414-962-9094 F 414-962-6498

ELEVATION

P & M PUB & GRUB
6533 WEST MITCHELL ST.
WEST ALLIS WISC. 53214
V 414-321-1419

98106

21 JUNE 99

6 OF 6

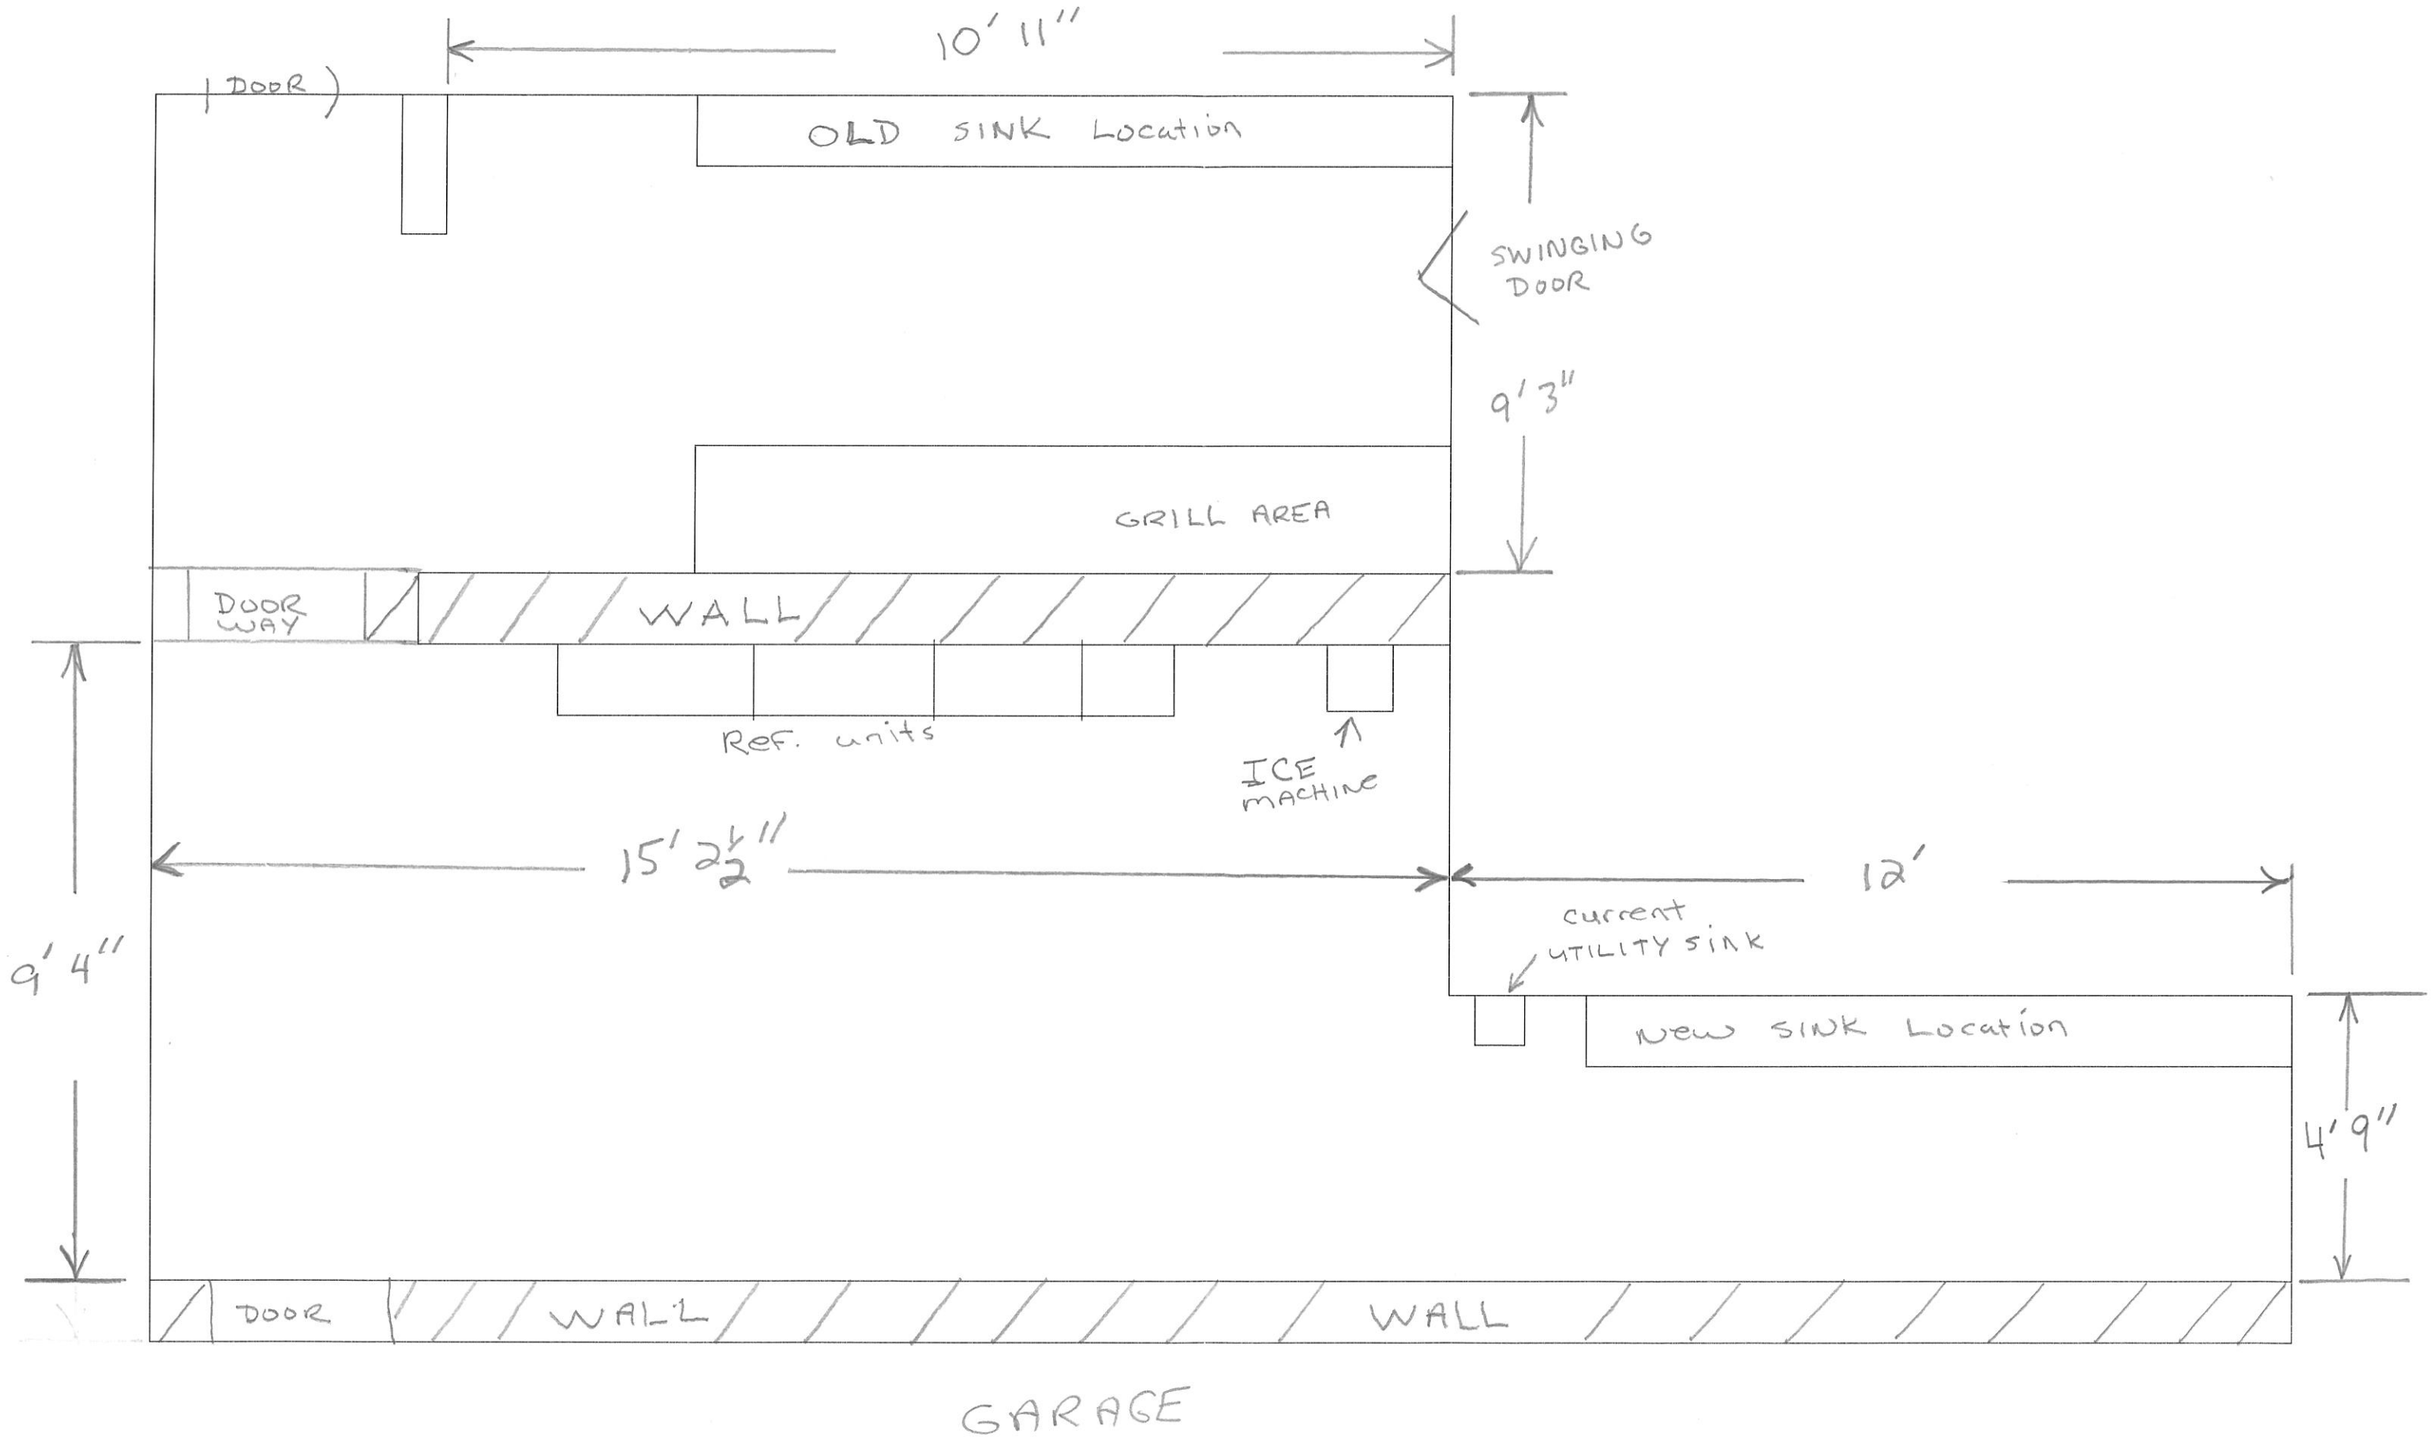
10' 11"
DOOR
OLD SINK Location
SWINGING DOOR
9' 3"
GRILL AREA
DOOR WAY
WALL
Ref. units
ICE MACHINE
9' 4"
15' 2½"
12'
current UTILITY SINK
New SINK Location
4' 9"
DOOR
WALL
WALL
GARAGE

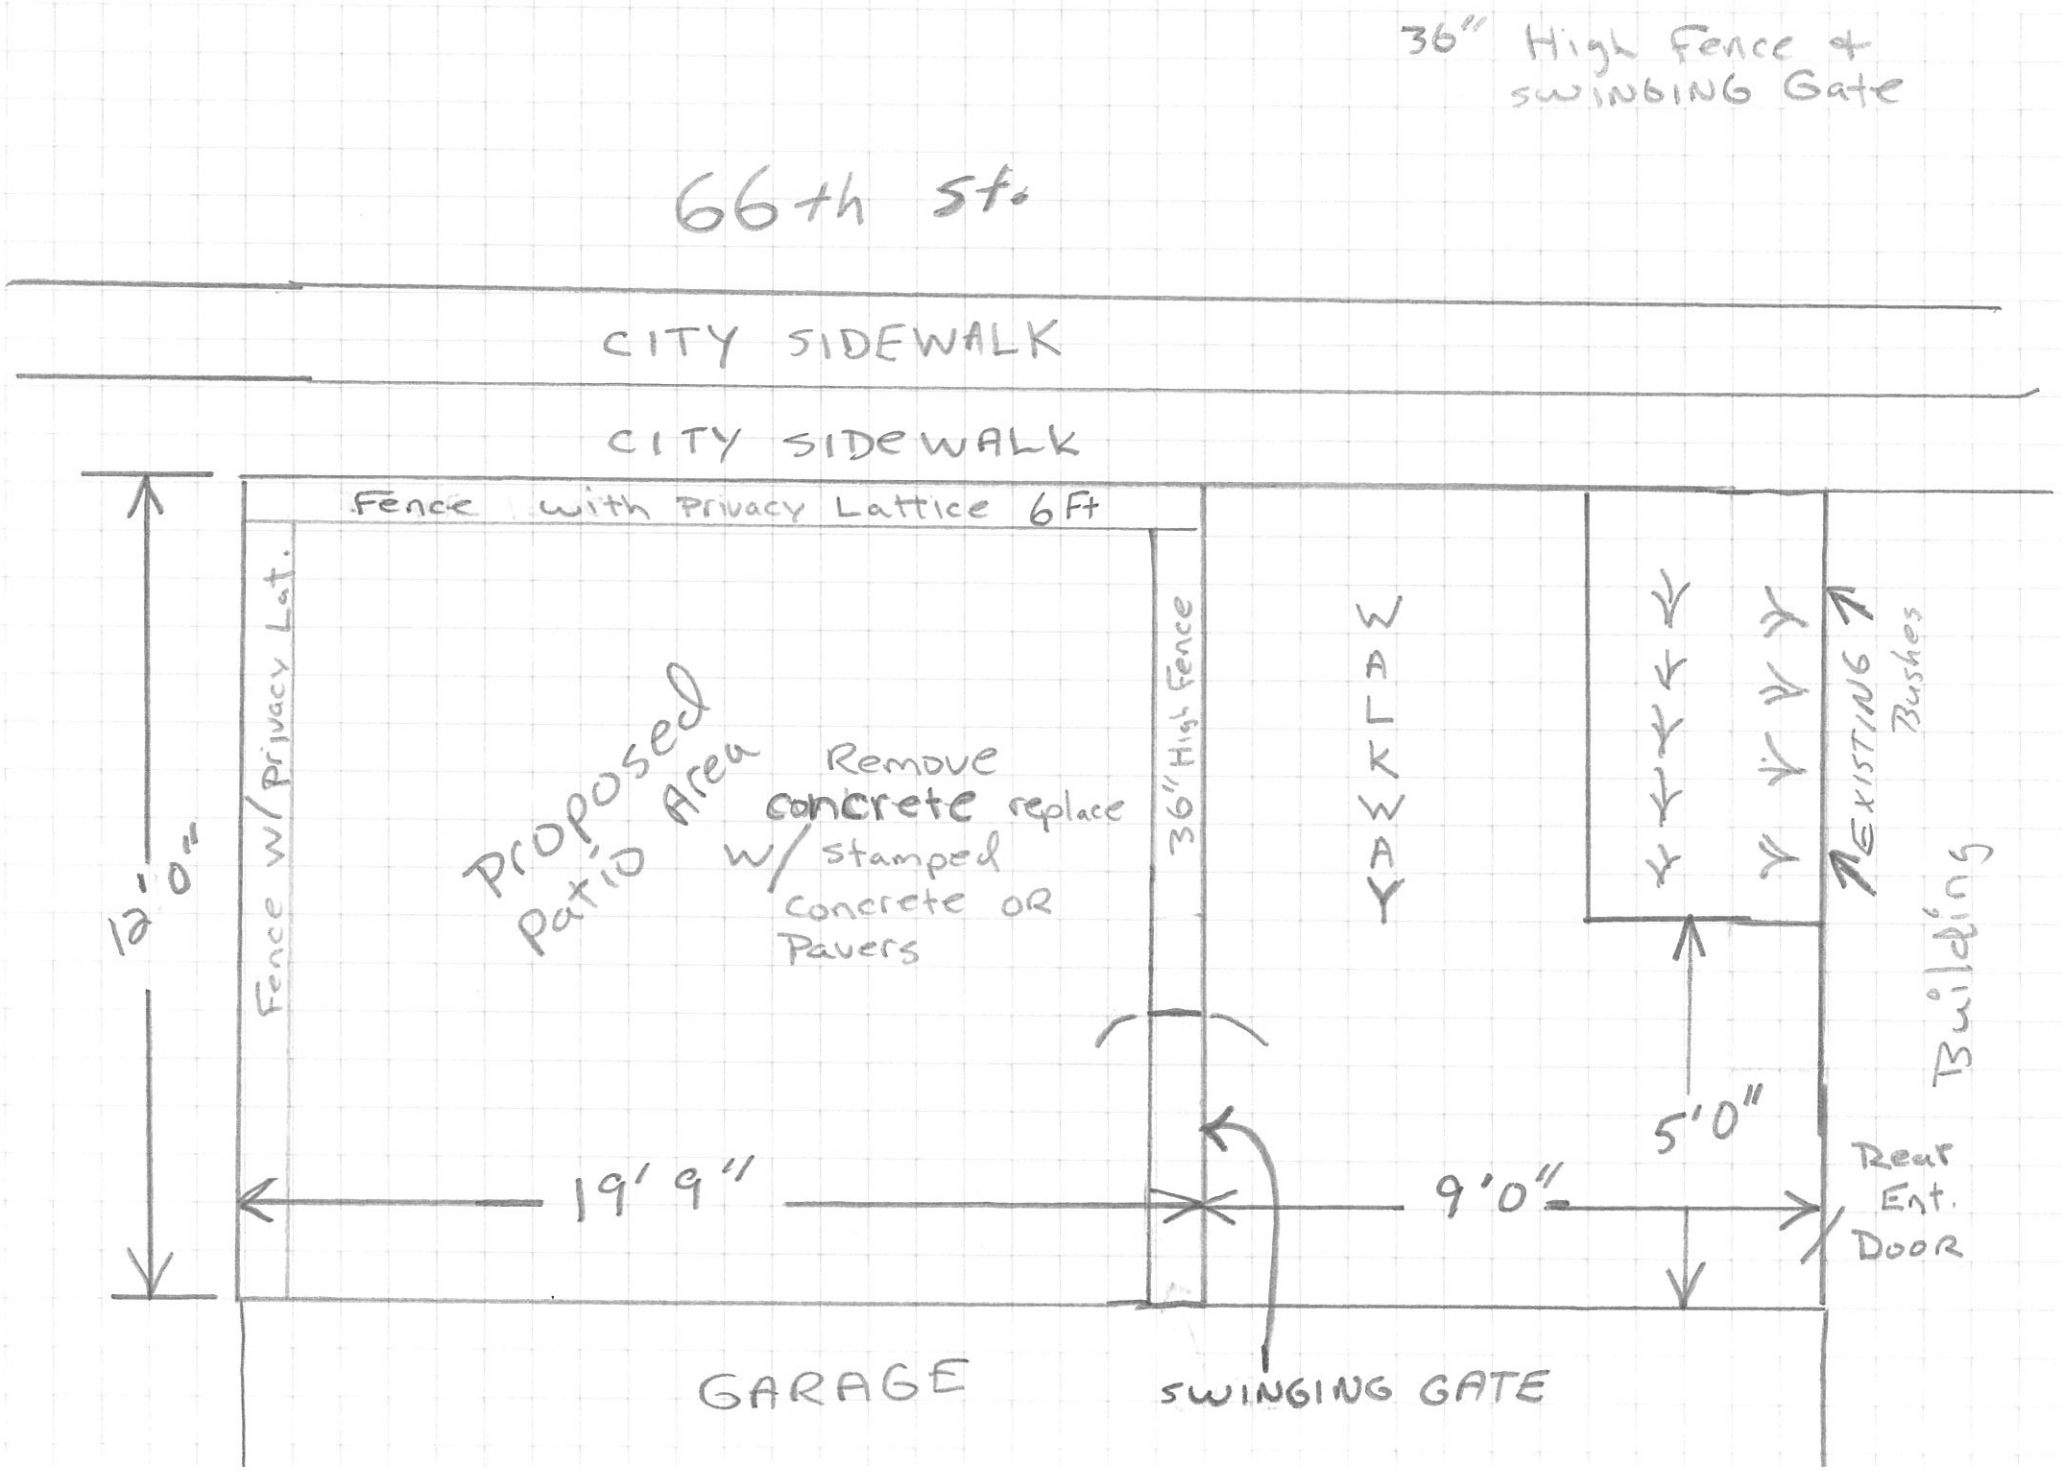
36" High Fence & SWINGING Gate
66th St.
CITY SIDEWALK
CITY SIDEWALK
Fence with Privacy Lattice 6Ft
Fence w/ Privacy Lat.
36" High Fence
WALKWAY
EXISTING Bushes
Building
Proposed Patio Area
Remove concrete replace w/ stamped concrete OR Pavers
12'0"
19'9"
9'0"
5'0"
Rear Ent. DOOR
GARAGE
SWINGING GATE